


DEPTH RANGES (300mm)		
FROM	TO	COLOUR
0.30	0.60	[Lightest Blue]
0.60	0.90	[Light Blue]
0.90	1.20	[Medium Light Blue]
1.20	1.50	[Medium Blue]
1.50	1.80	[Dark Medium Blue]
1.80	2.10	[Dark Blue]
2.10	2.40	[Darkest Blue]
2.40	+	[Black]

GENERAL NOTES

1. THIS PLAN SHOWS DETAILS OF FILLING CARRIED OUT AS PART OF WORKS ON GOLDEN GROVE ESTATE
2. FILL DEPTHS ARE APPROXIMATE & INDICATIVE ONLY AND THIS PLAN SHOULD BE CONSIDERED IN CONJUNCTION WITH SITE INVESTIGATIONS CARRIED OUT BY GEOTECHNICAL TESTING SERVICES
3. THIS PLAN DOES NOT SHOW ANY OTHER FILL WHICH MAY HAVE BEEN PLACED PRIOR TO RESIDENTIAL SUBDIVISION OF THE LAND. ANY GRADING OR SPREADING TO CORRECT MINOR SURFACE IRREGULARITIES LESS THAN 300mm IS NOT SHOWN. DEPTHS SHOWN ARE NOT RECOMMENDED FOUNDATION DEPTHS.

file name: 304068FP1_FILL_PLAN.dwg, layout name: G500, plotted by: Harry Oakley-Warren
 file location: G:\304068FP1\A1.dwg, plot date: 07/06/2018 6:54 PM, sheet: 1 of 1

Rev	Amendments	Approved	Date
1	AMENDED FILL LEGEND	B. I.	1/08/18
0	AS CONSTRUCTED FILL PLAN	B. I.	15/06/18

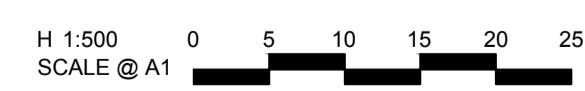

© Spiire Australia Pty Ltd All Rights Reserved
 This document is produced by Spiire Australia Pty Ltd solely for the benefit of and use by the client in accordance with the terms of the retainer. Spiire Australia Pty Ltd does not and shall not assume any responsibility or liability whatsoever to any third party arising out of any use or reliance by third party on the content of this document.

16 Bridge Street Bendigo
 Victoria 3550 Australia T 61 3 5448 2500
 spiire.com.au ABN 55 050 029 635

Designed H. OAKLEY-WARREN	Checked B. IBBS
Authorised B. IBBS	Date 15/06/18

**GOLDEN GROVE ESTATE STAGE 1
 HARVEYS LANE, JACKASS FLAT
 AS CONSTRUCTED FILL PLAN
 FACE PLAN
 CITY OF GREATER BENDIGO
 WARRINGAL VIEWS P/L**

AS CONSTRUCTED Drg No **304068FP1** Rev **1**